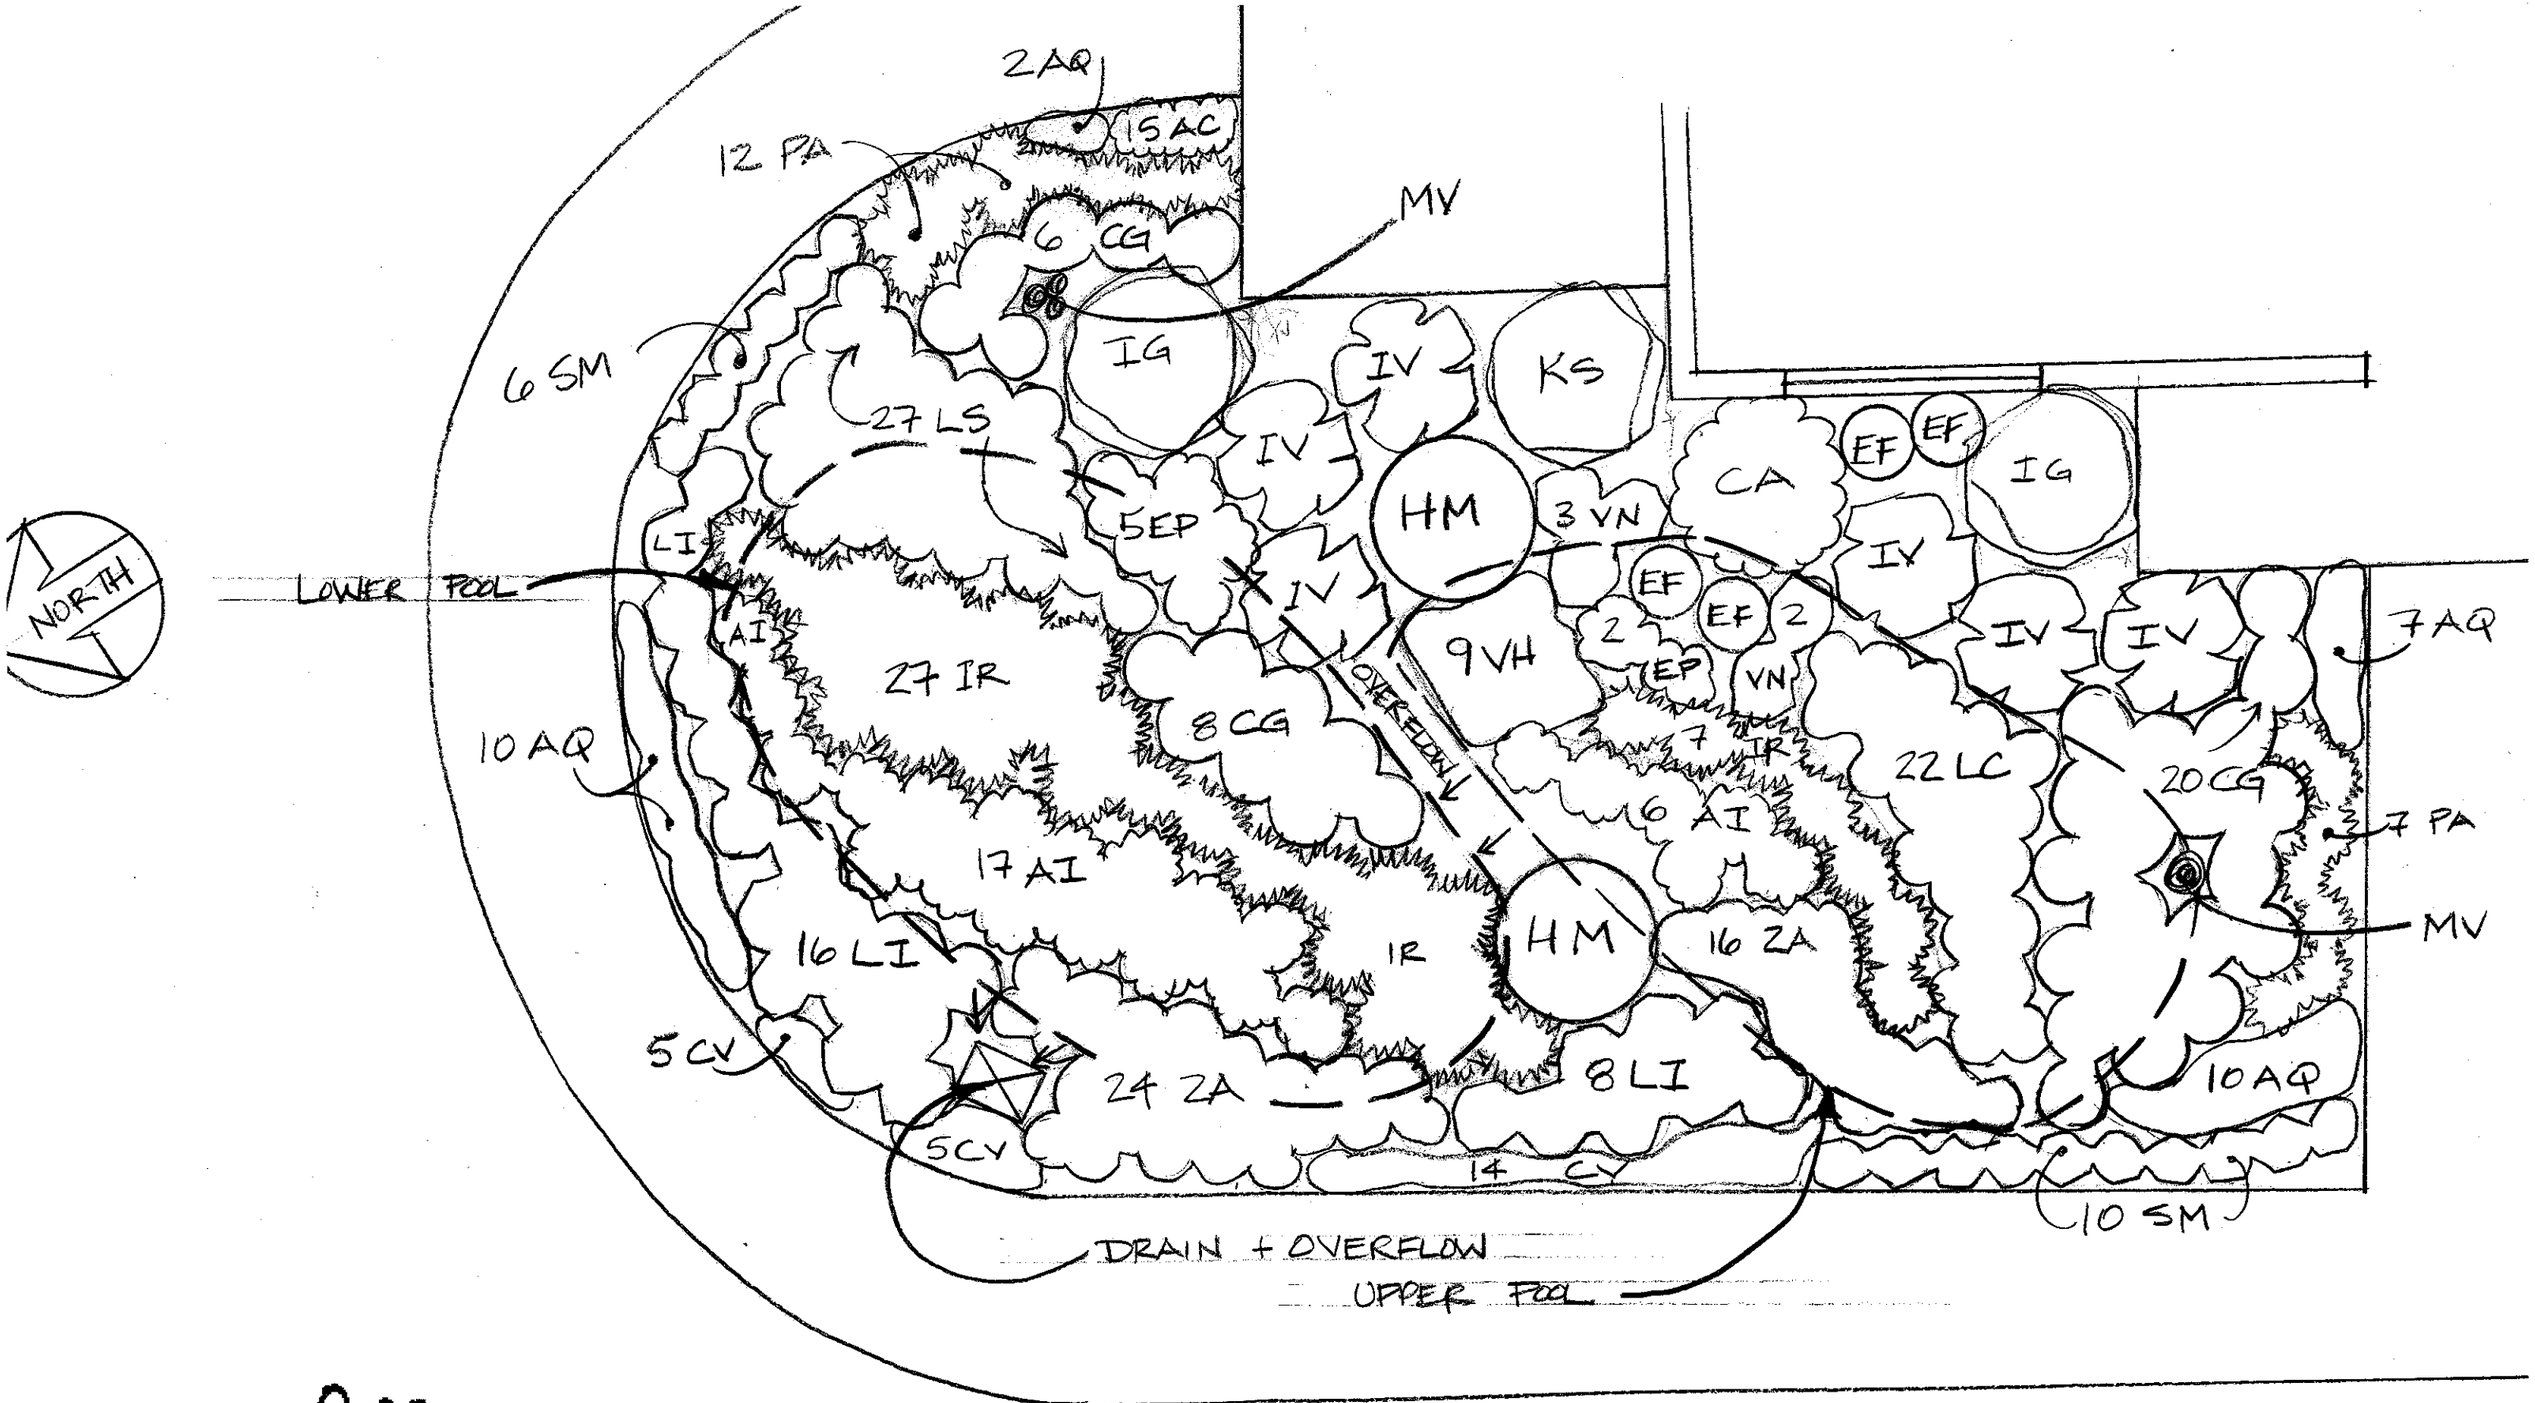

BLACKBIRD FOREST RAIN GARDEN

FEBRUARY 2011

SCALE 1"= 4'-0"

PLANNING & GARDEN DESIGN
GUIDED PATH

Blackbird Forest Rain Garden Plants

Code	Latin name	Common Name	Spacing	Quantity	NEW #	
AC	Asarum canadensis	Wild Ginger	8"	15		
AI	Asclepias incarnata	Swamp Milkweed	24"	23		
AQ	Aqualegia canadensis	Wild Columbine	15"	29		
CA	Clethra alnifolia	Summersweet Clethra		1		
CG	Chelone glabra	Turtlehead	24"	~~35~~	**34**	
CV	Chrysogonum virgatum	Green & Gold	15"	24		
EF	Eupatorium fistulosum or dubium	Joe Pye Weed	24"	4		
EP	Eupatorium perfoliatum	Boneset	24"	7		
HM	Hibiscus moeschutos	Swamp Mallow		2		
IR	Iris versicolor	Blueflag	24"	~~39~~	**34**	
IV	Itea virginica	Virginia Sweetspire		5		
LC	Lobelia cardinalis	Cardinal Flower	18"	22		
LI	Liatris spicata	Blazing Star	24"	24		
LS	Lobelia siliphitica	Blue Lobelia	18"	27		
PA	Polystichum acrostichoides	Christmas Fern	18"	18		
SM	Spigellia marlandica	Indian Pink	18"	16		
VH	Verbenia hastata	Blue Vervain	18"	4	**9**	
VN	Vernonia novaeboracensis	New York Ironweed	24"	5		
ZA	Zizia aurea	Golden Alexanders	18"	~~41~~	**40**	
	Existing plants to be transplanted					
MV	Magnolia virginiana	Sweetbay Magnolia		2		
IG	Ilex glabra	Inkberry Holly		2		
KS	Kalmia Sarah	Mountain Laurel		1		
IV	Itea virginica	Virginia Sweetspire		1		
	Existing Plants to be moved elswhere					
	Kalmia Sarah	Mountain Laurel		1		
	Hydrangea quercifolia	Oakleaf Hydrangea		1		